



1B1B - 710 SF



2B1B - 898 SF

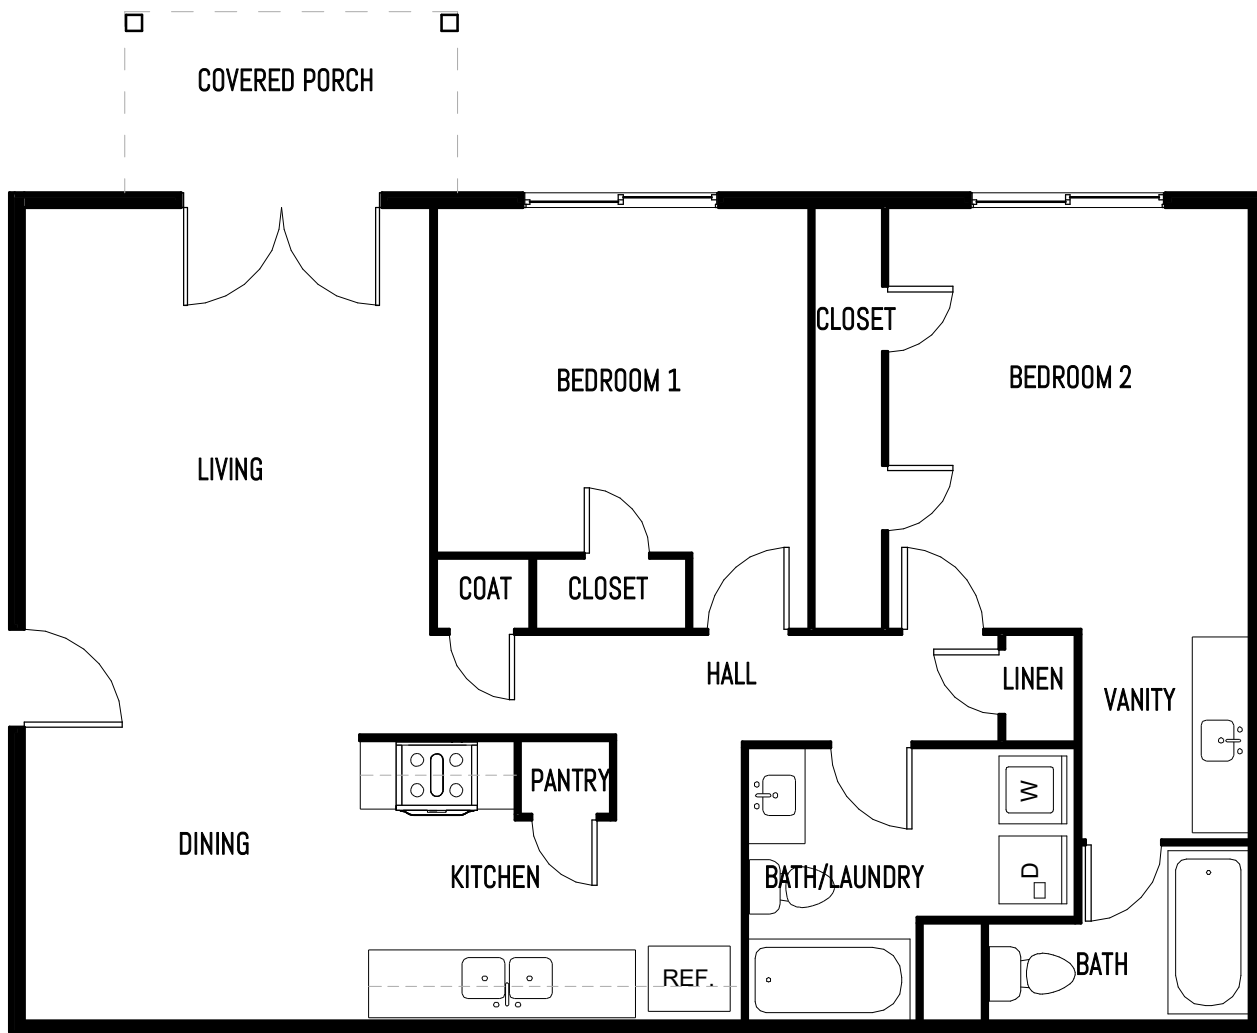

2B2B - 950 SF

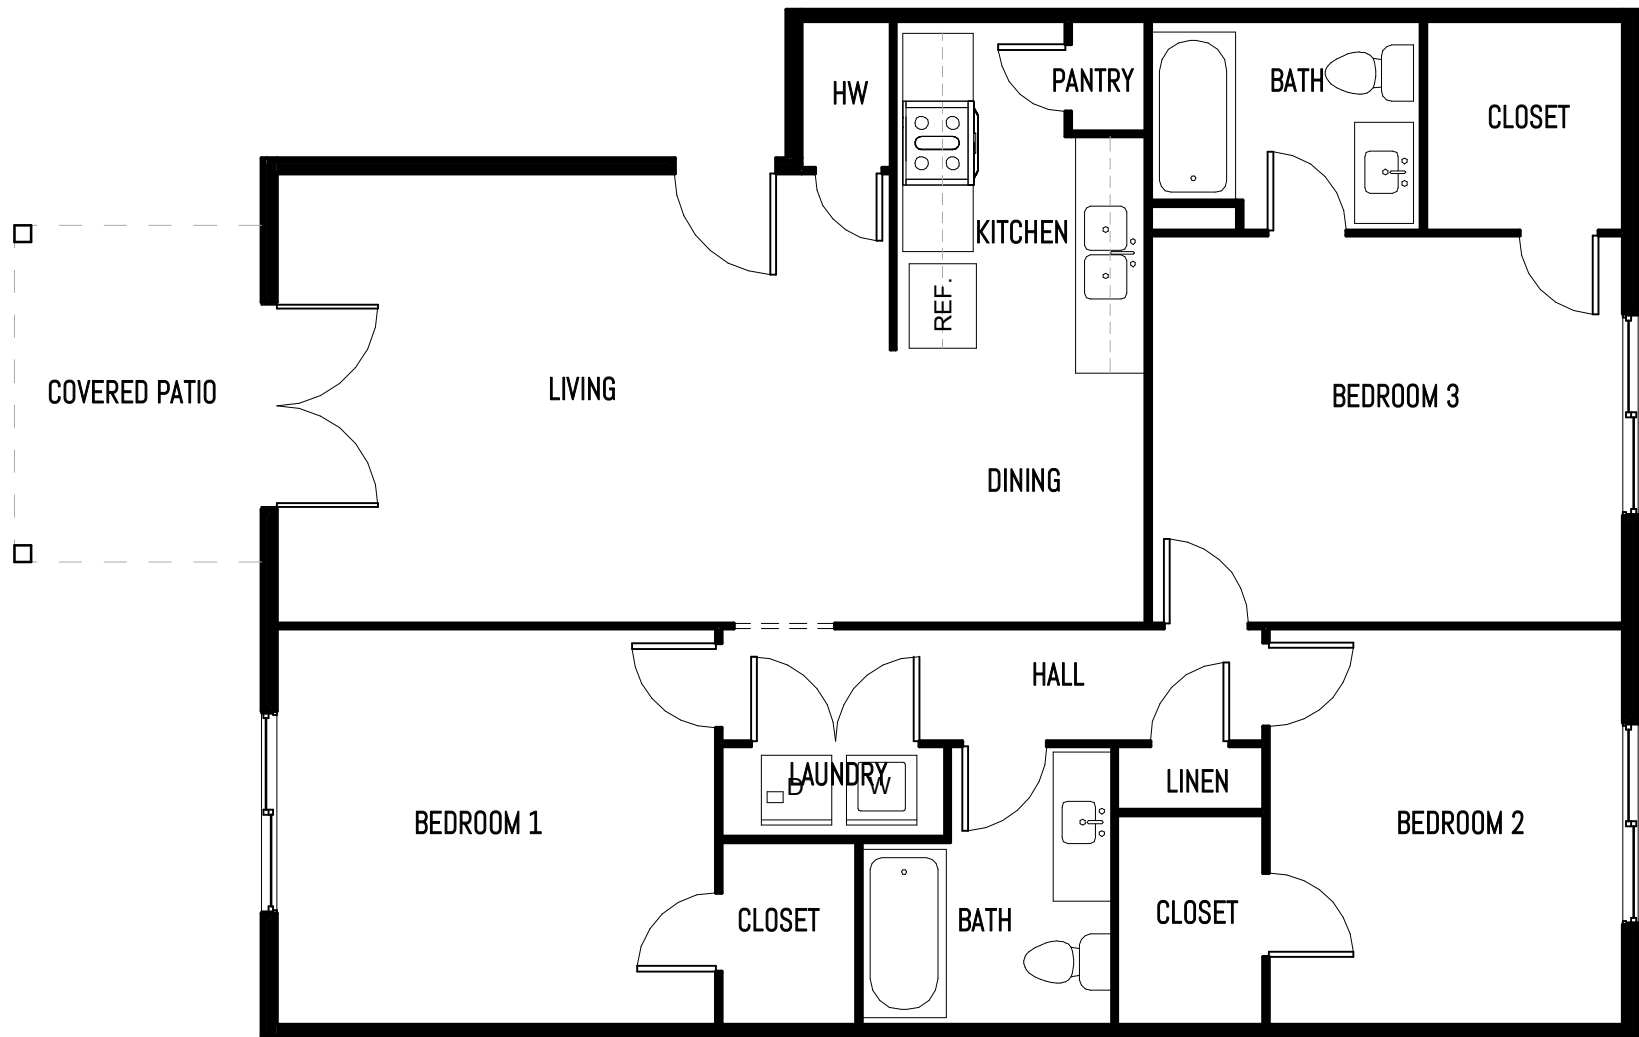

3B2B - 1,143 SF